


REVISIONS				
ZONE	REV.	DESCRIPTION	DRAWN	CHECKED
A		AS BUILT JUNE 2001	DLH	
			20 JUN 01	

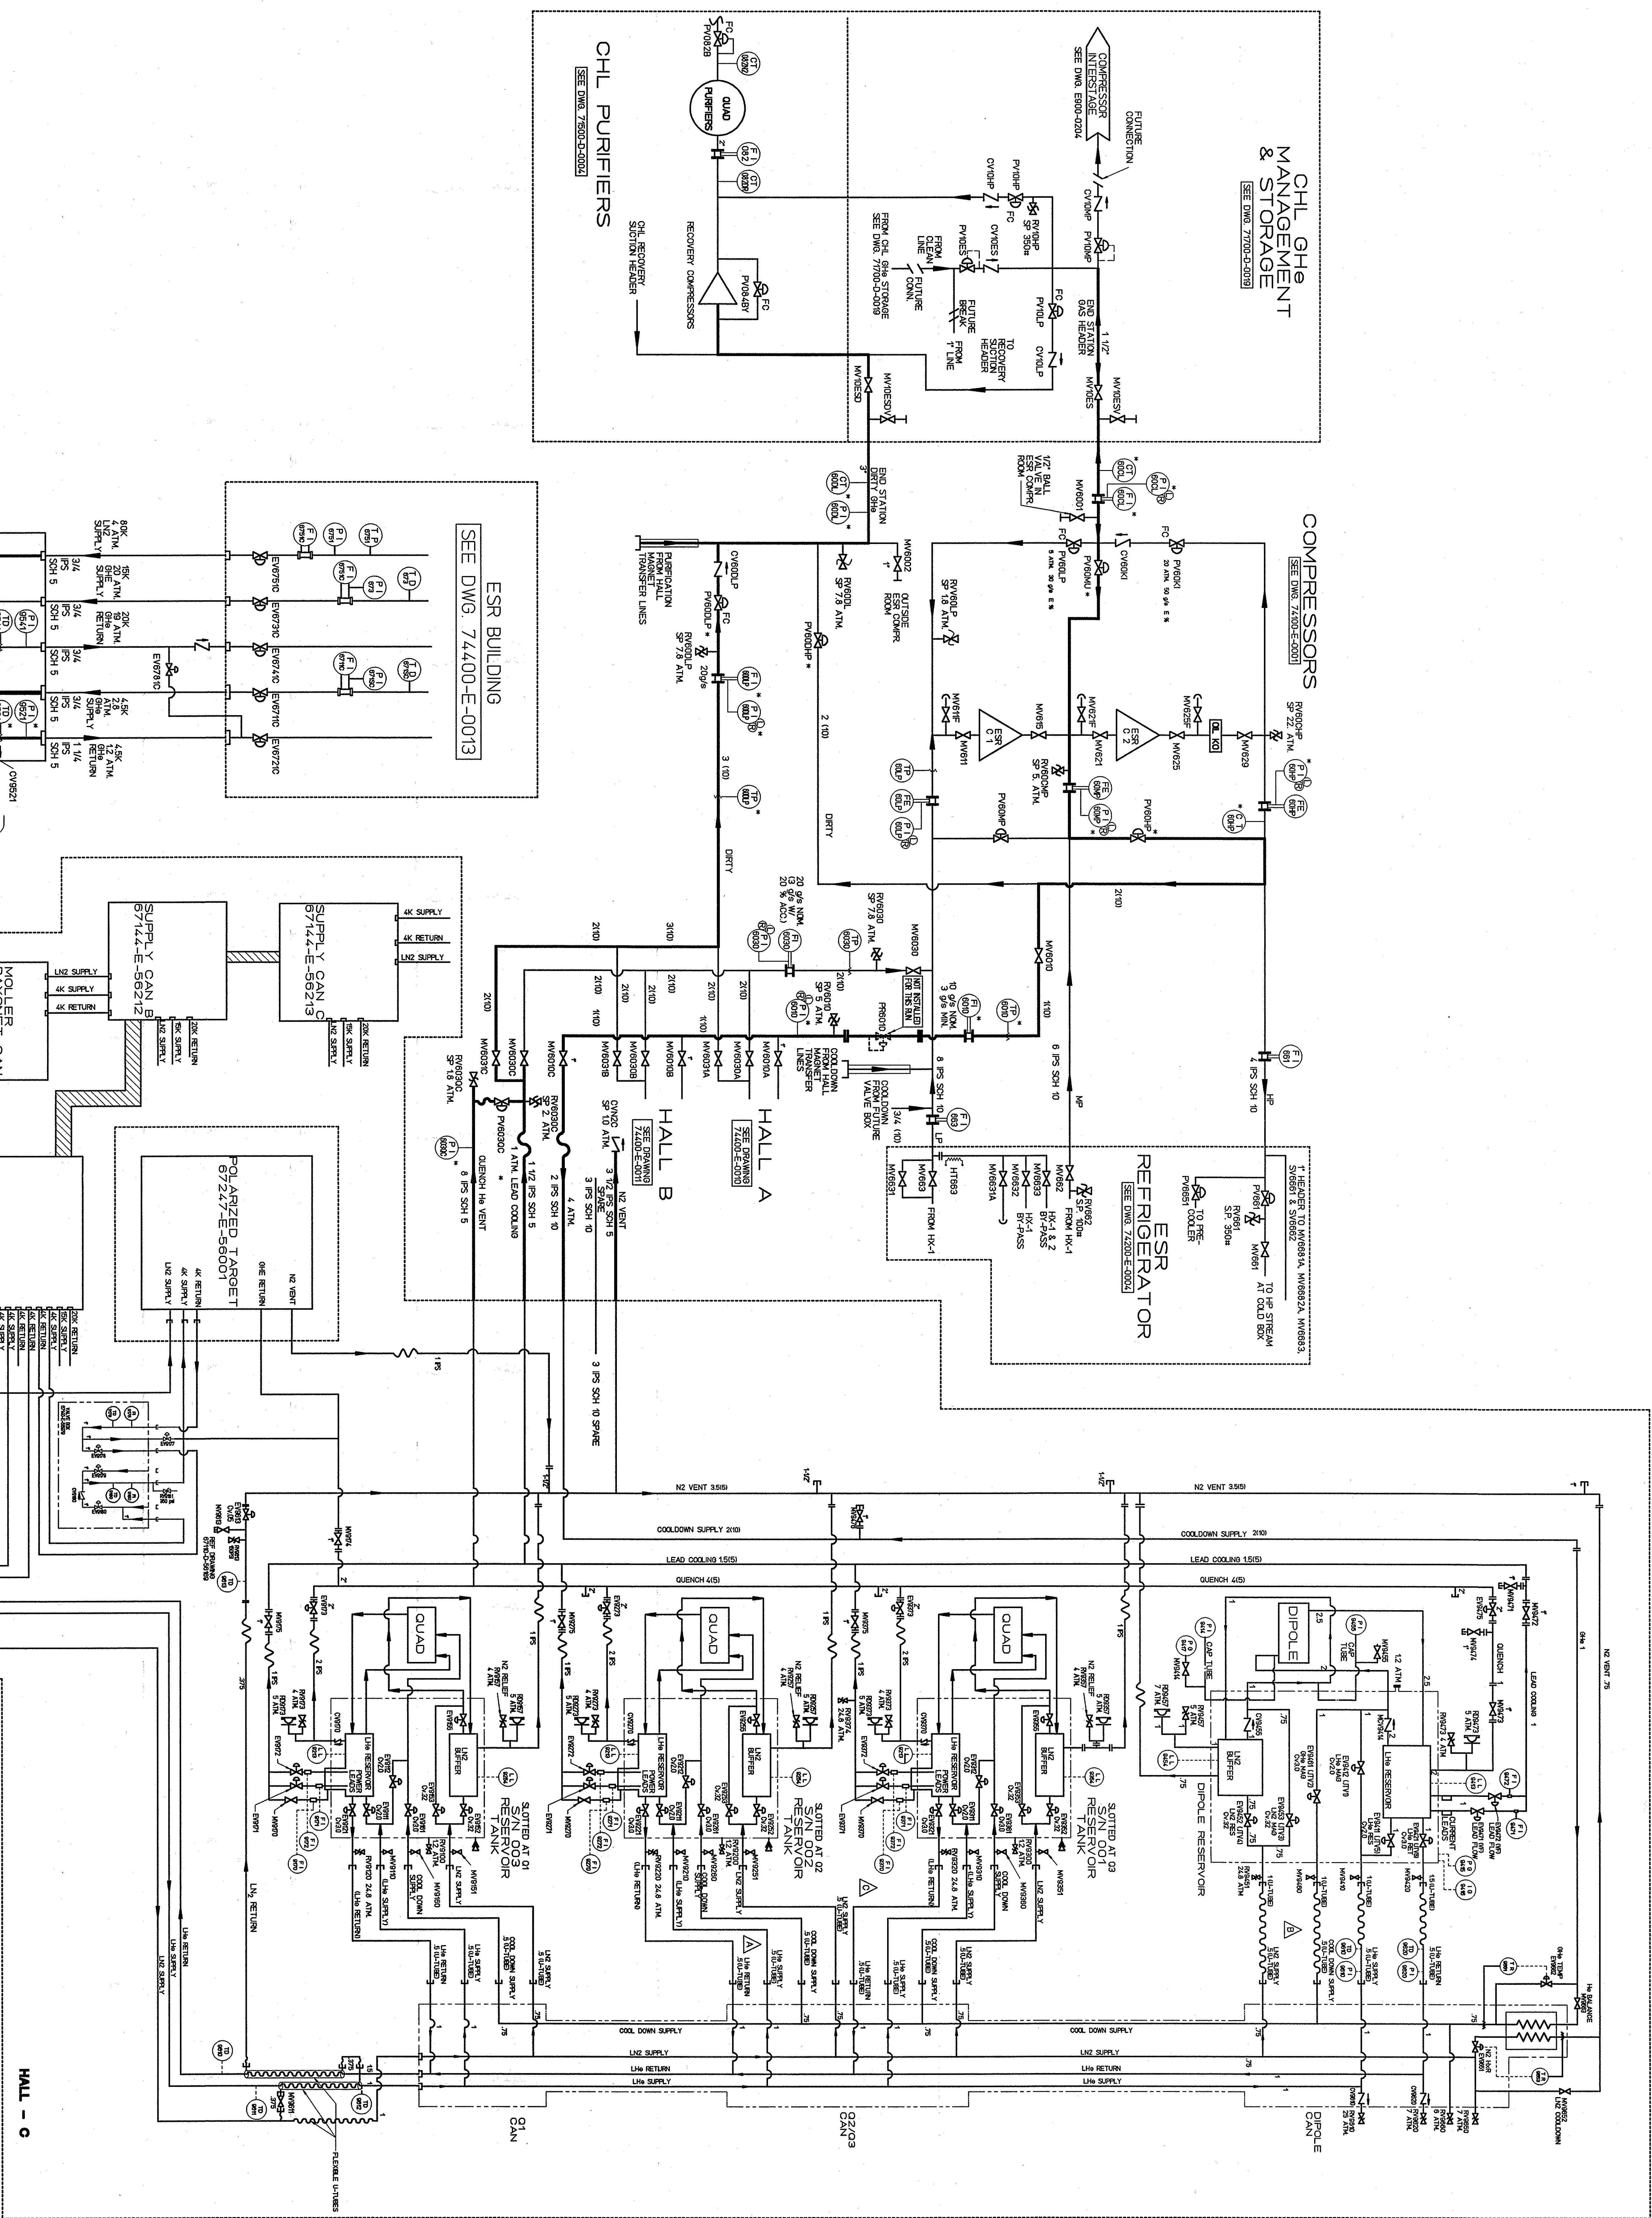

ON A 1/8" GRID, ALL DIMENSIONS ARE IN INCHES DIMENSIONS IN PARENTHESES ARE IN MILLIMETERS		CAD FILE PWS(06/01/17) JUSWISW(06/01/17) TROLL C(07/14/01)50960	
MATERIAL N/A	APPROVALS JAMES J TAKKAS JAMES J TAKKAS	DATE 11-11-86 15-11-86	 JAMES J. TAKKAS PROFESSIONAL ENGINEER STATE OF NEW YORK NO. 10000 EXPIRATION DATE 12/31/2018
FINISH ✓ OTHERS REBAR, & REINFL. ANCH. RODS	APPROVED BY N/A	APPROVED FOR 7-16-86	
DO NOT SCALE DRAWING	SHEETING NO. E	SHEET 67140-E-56960	
	DESIGNED BY N/A	REV 1 OF 1 A	