


REVISIONS		DESCRIPTION	DRAWN	CHECKED
ZONE	REV		DJH	
A		AS BUILT JUNE 2001	ZOUNG	7-7-94

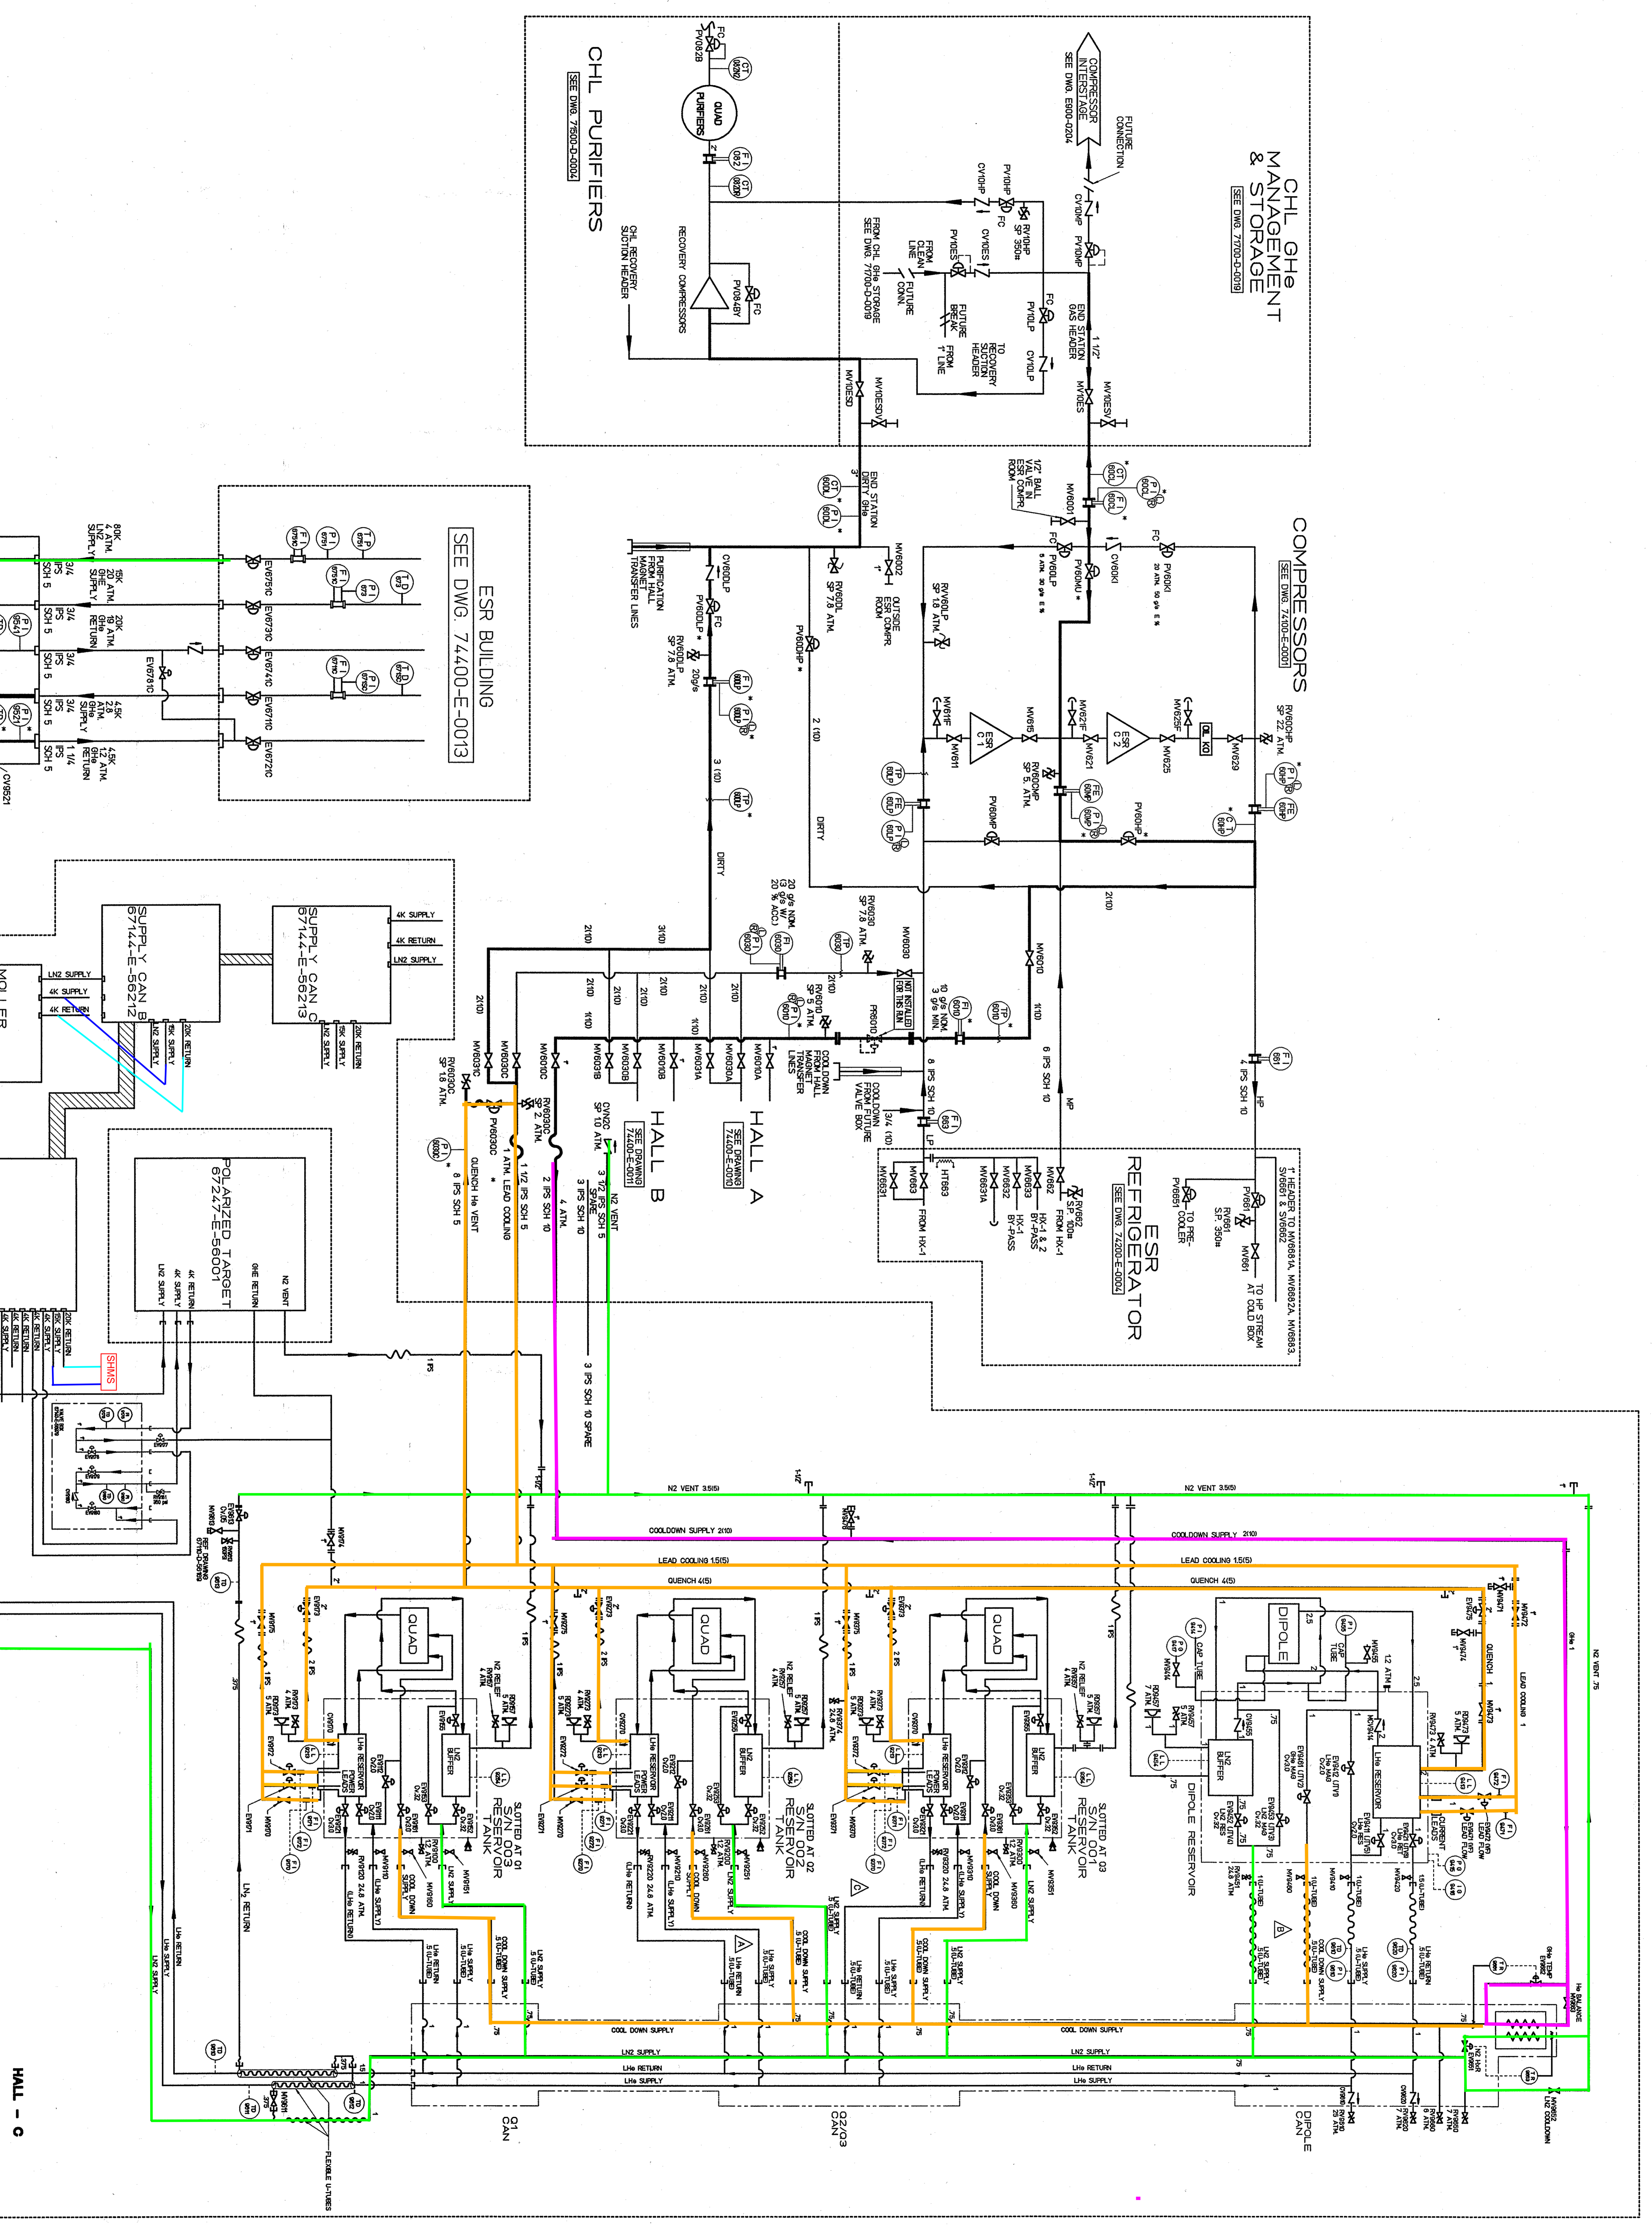

DO NOT SCALE DRAWING		HALL C FLOW DIAGRAM 4.5K SUPPLY, 20K RETURN		REV
DATE	11/1/96	DESIGNED BY	67140-E-56960	A
CHECKED	JAMES I. TAKACS	APPROVED FOR CONSTRUCTION		
DRAWN	11/1/96			
DATE				
APPROVALS				
DESIGNED BY	67140-E-56960			
DATE				
APPROVALS				
DESIGNED BY	67140-E-56960			
DATE				
APPROVALS				