
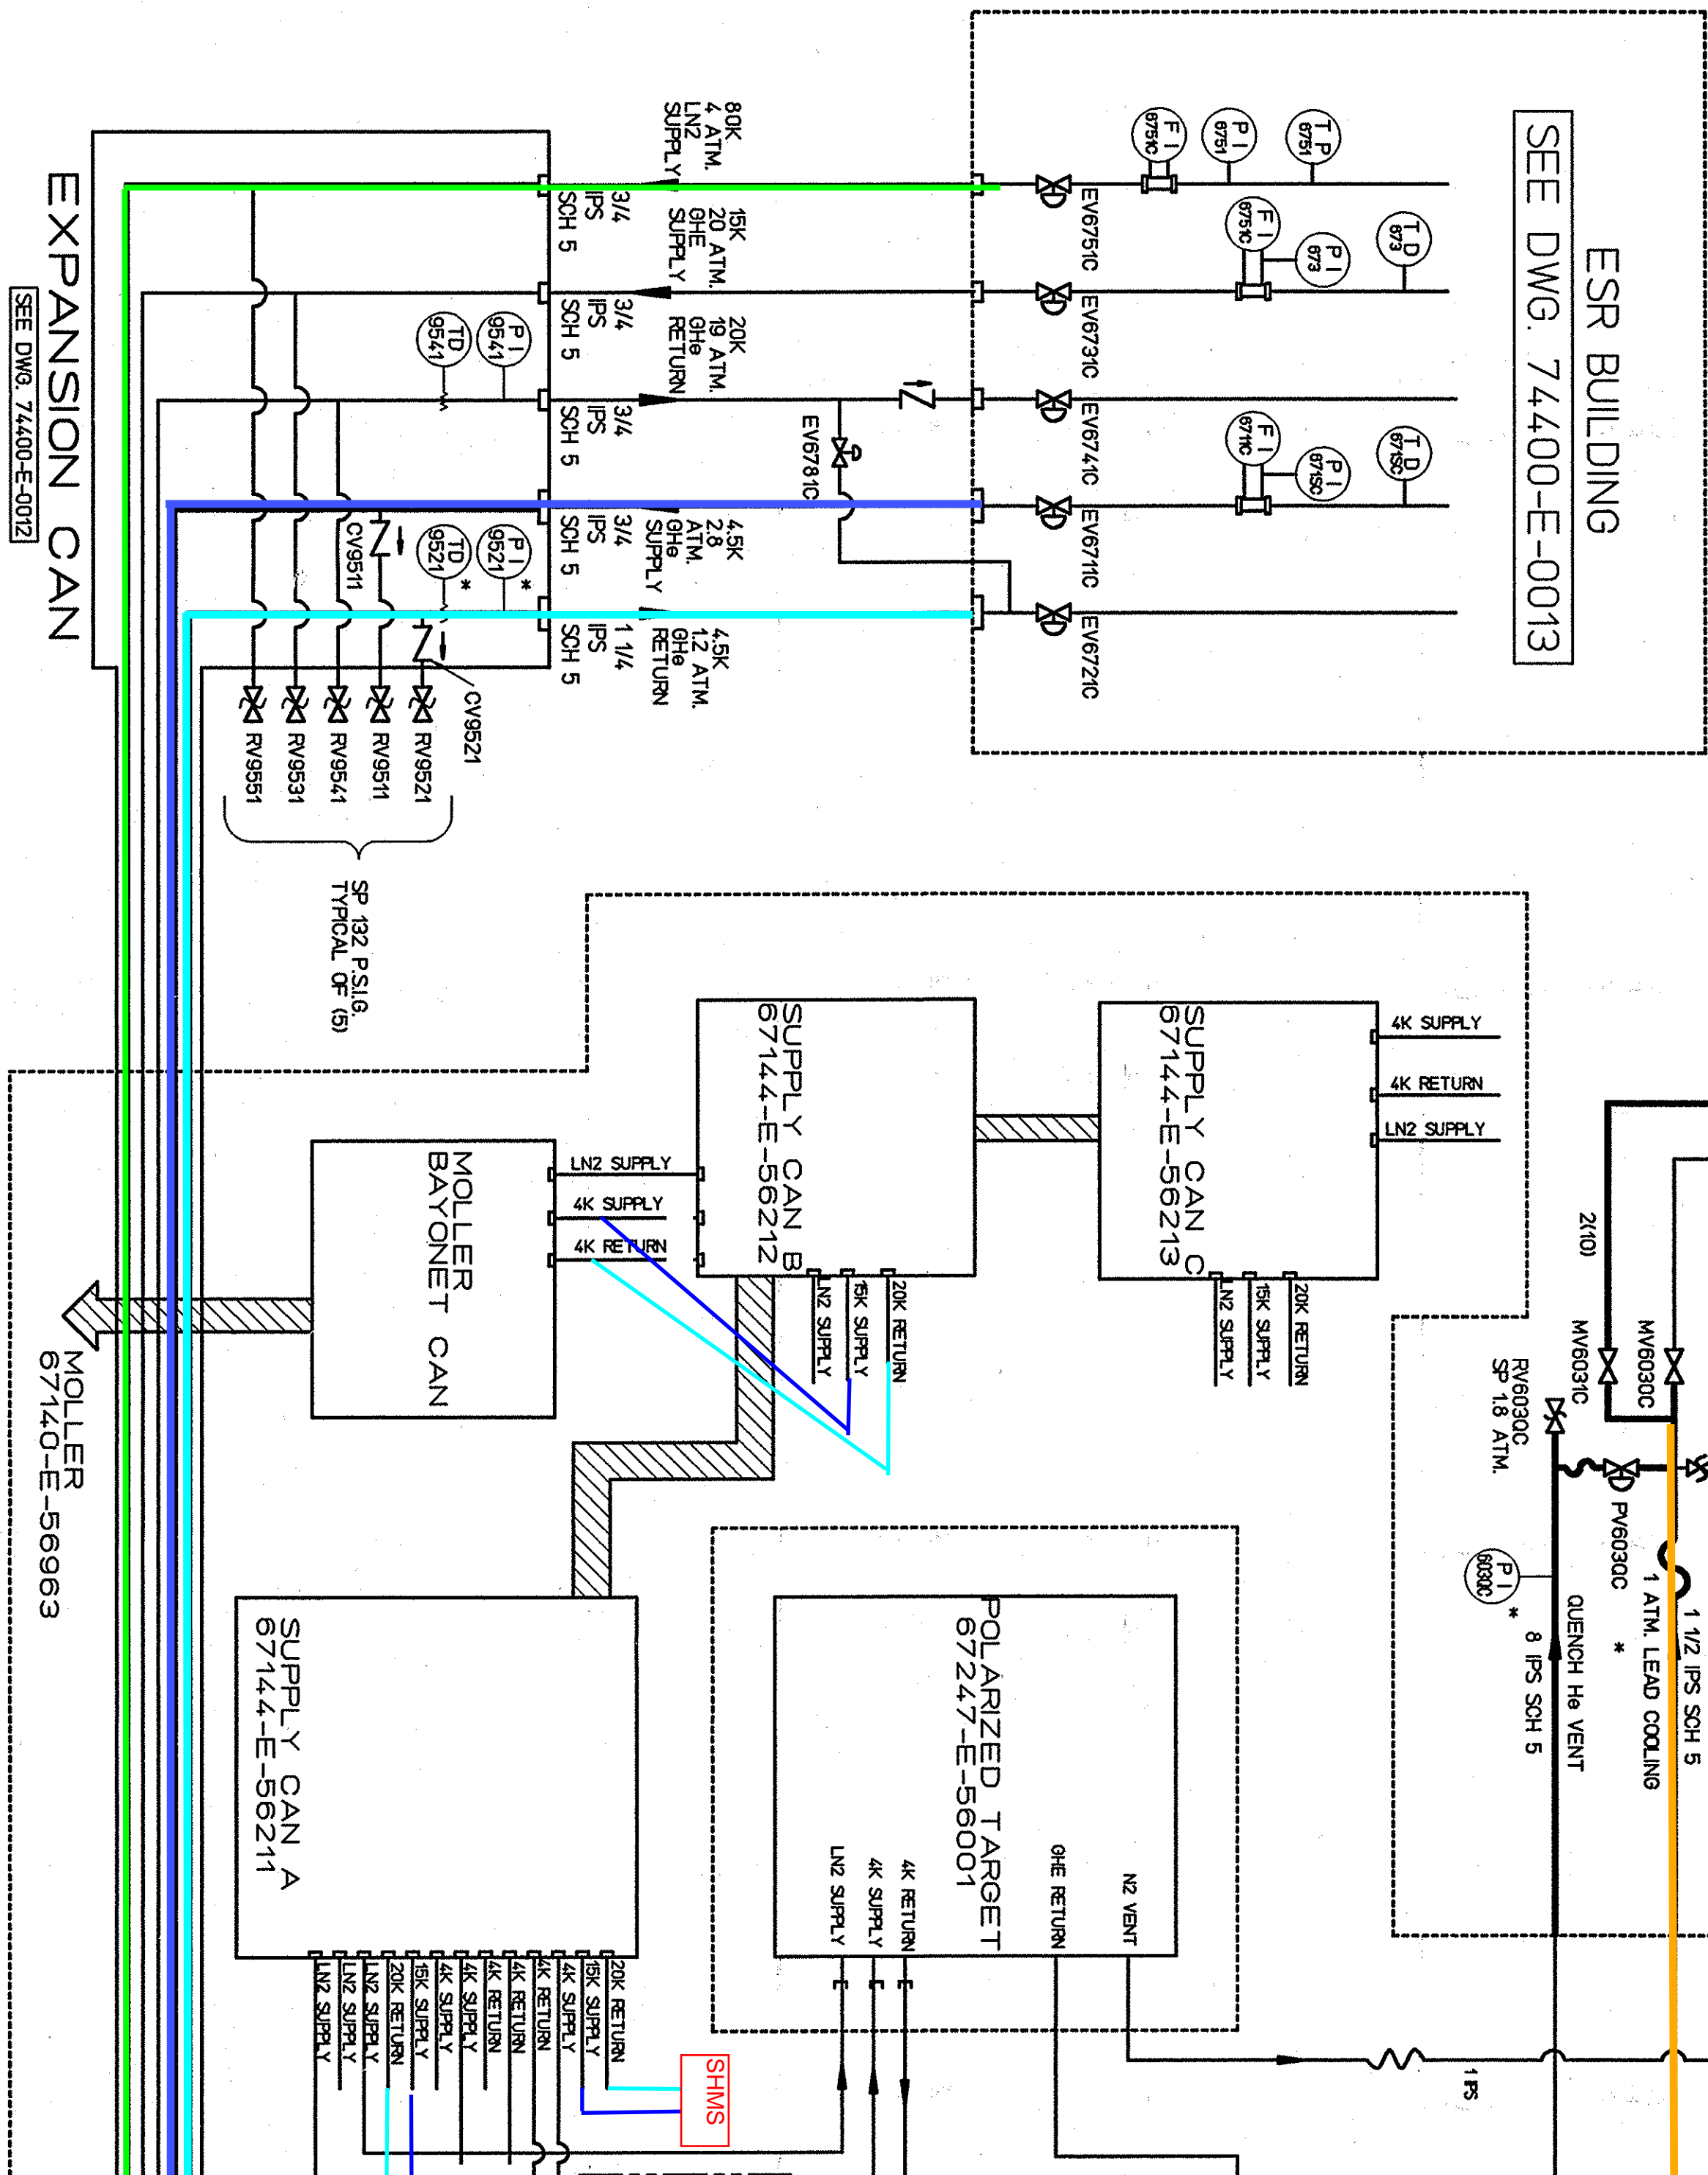
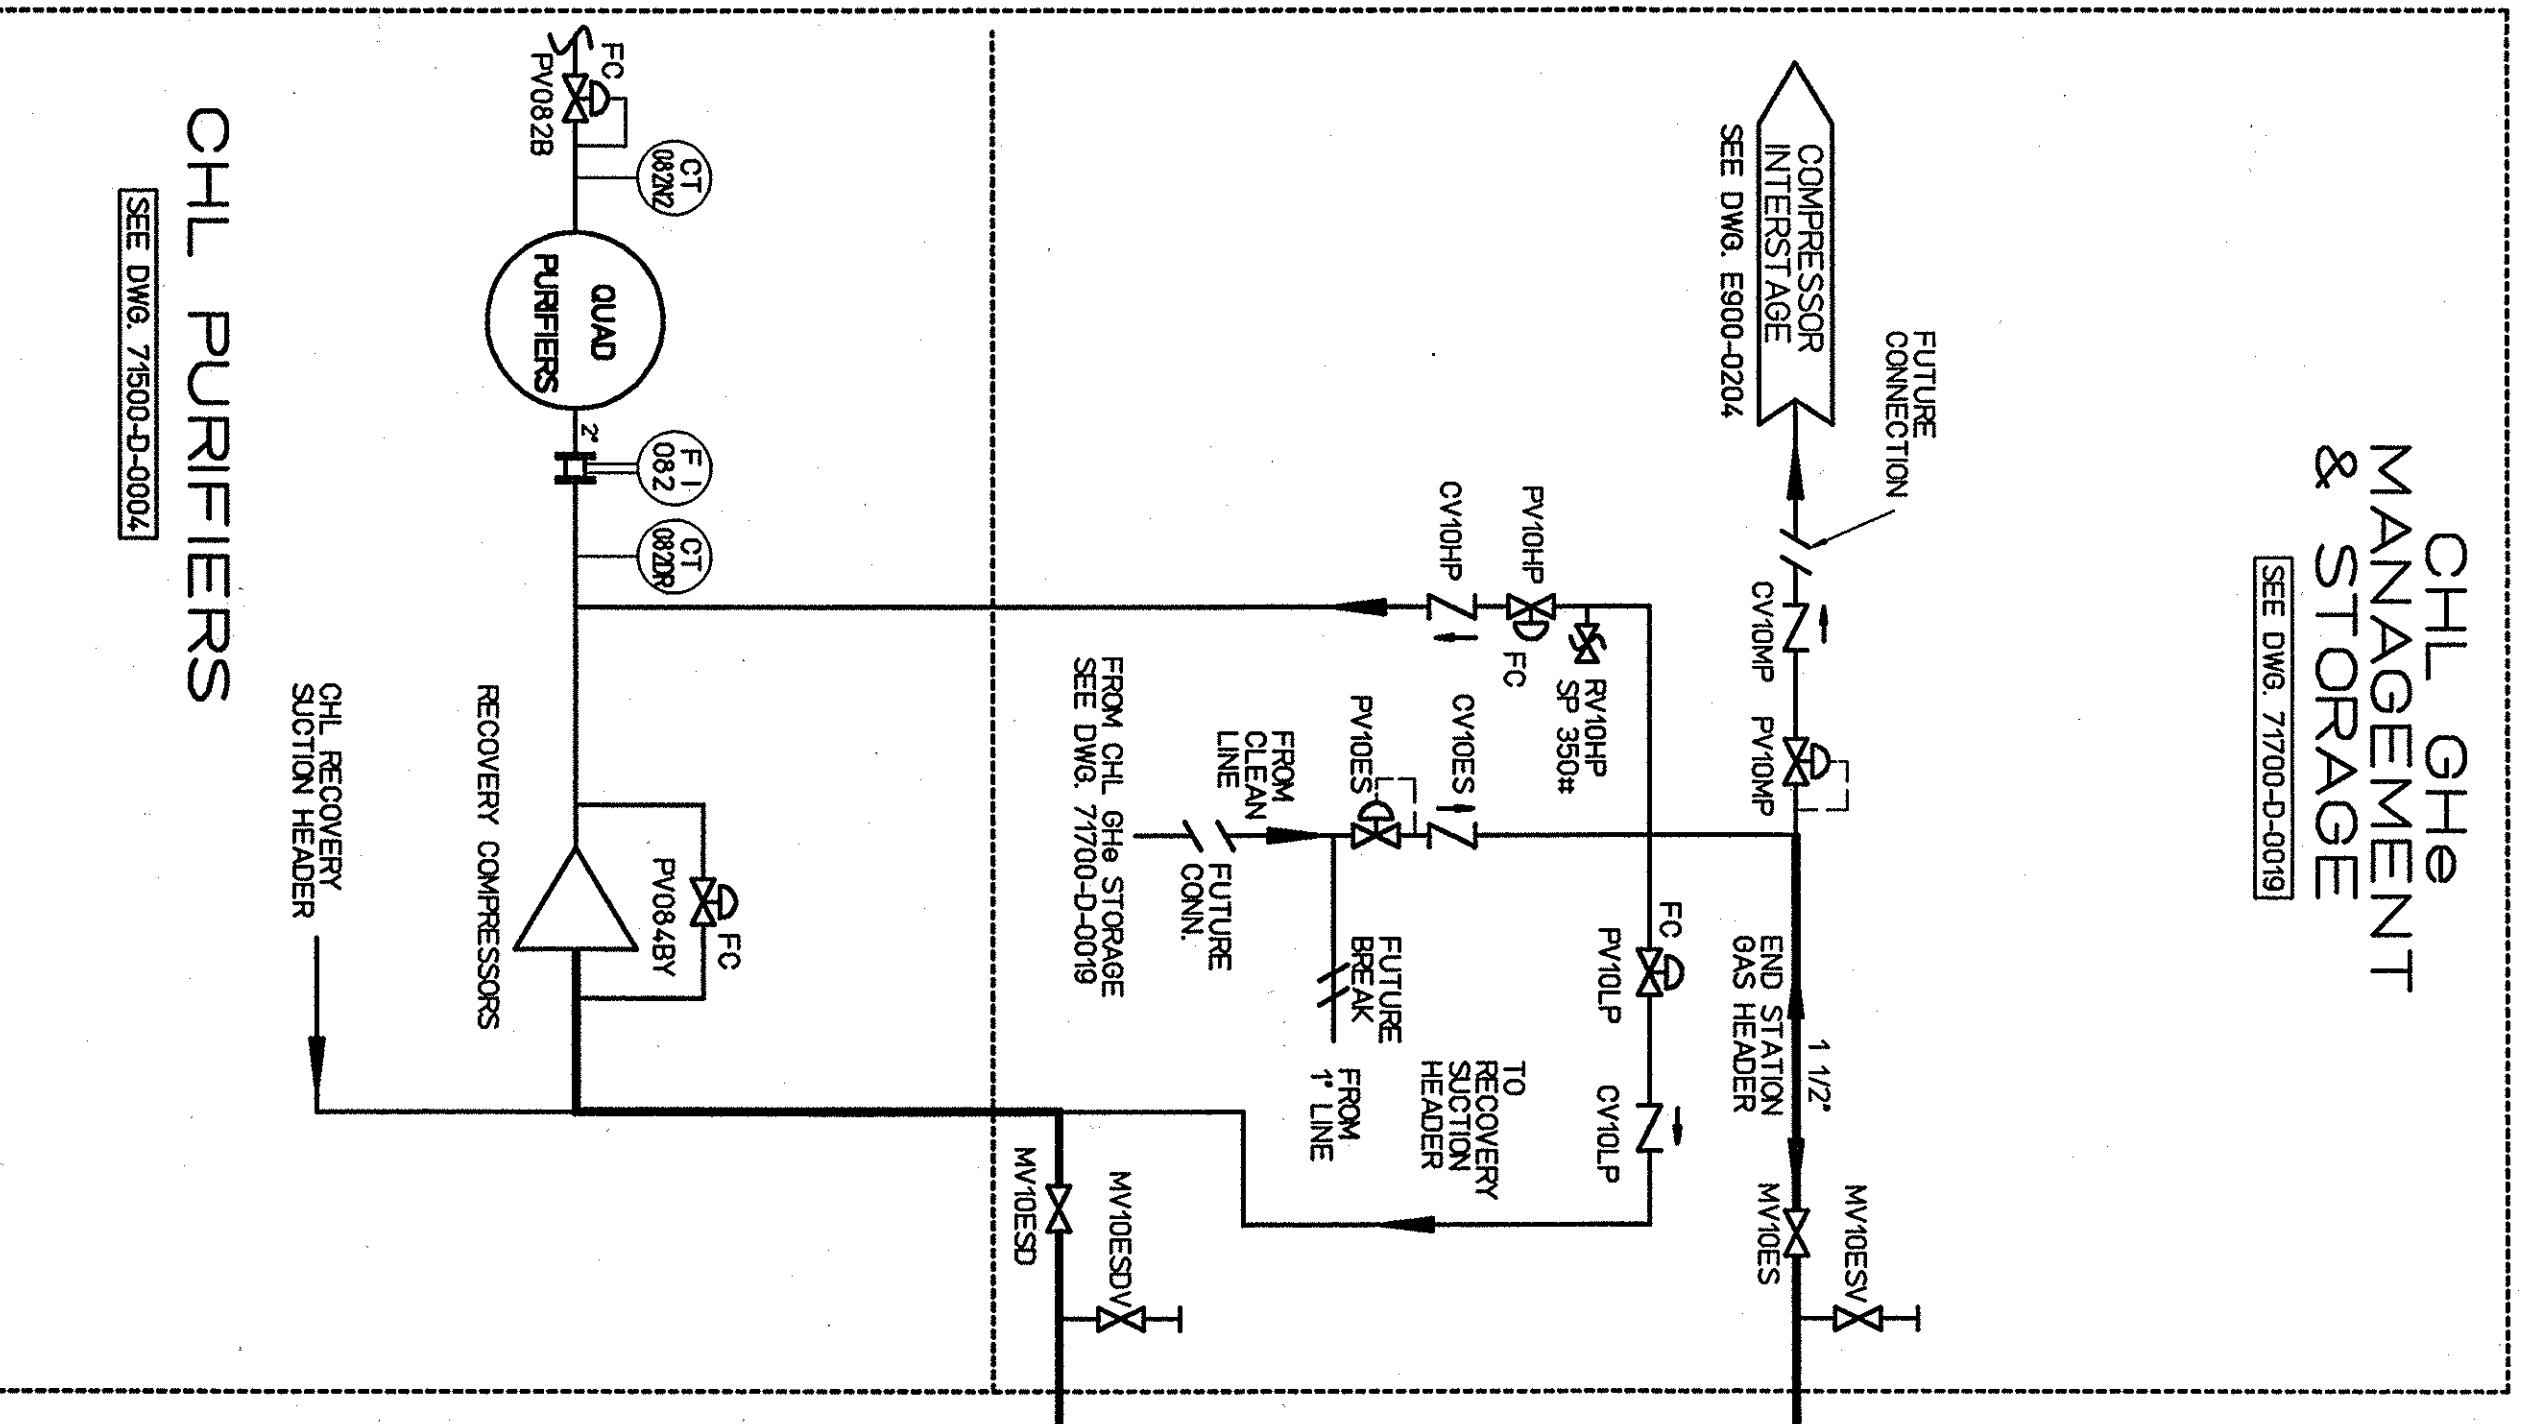


REVISIONS		DESCRIPTION	DRAWN	CHECKED
ZONE	REV		DH	
A		AS BUILT JUNE 2001	ZOUNG	7-7-94

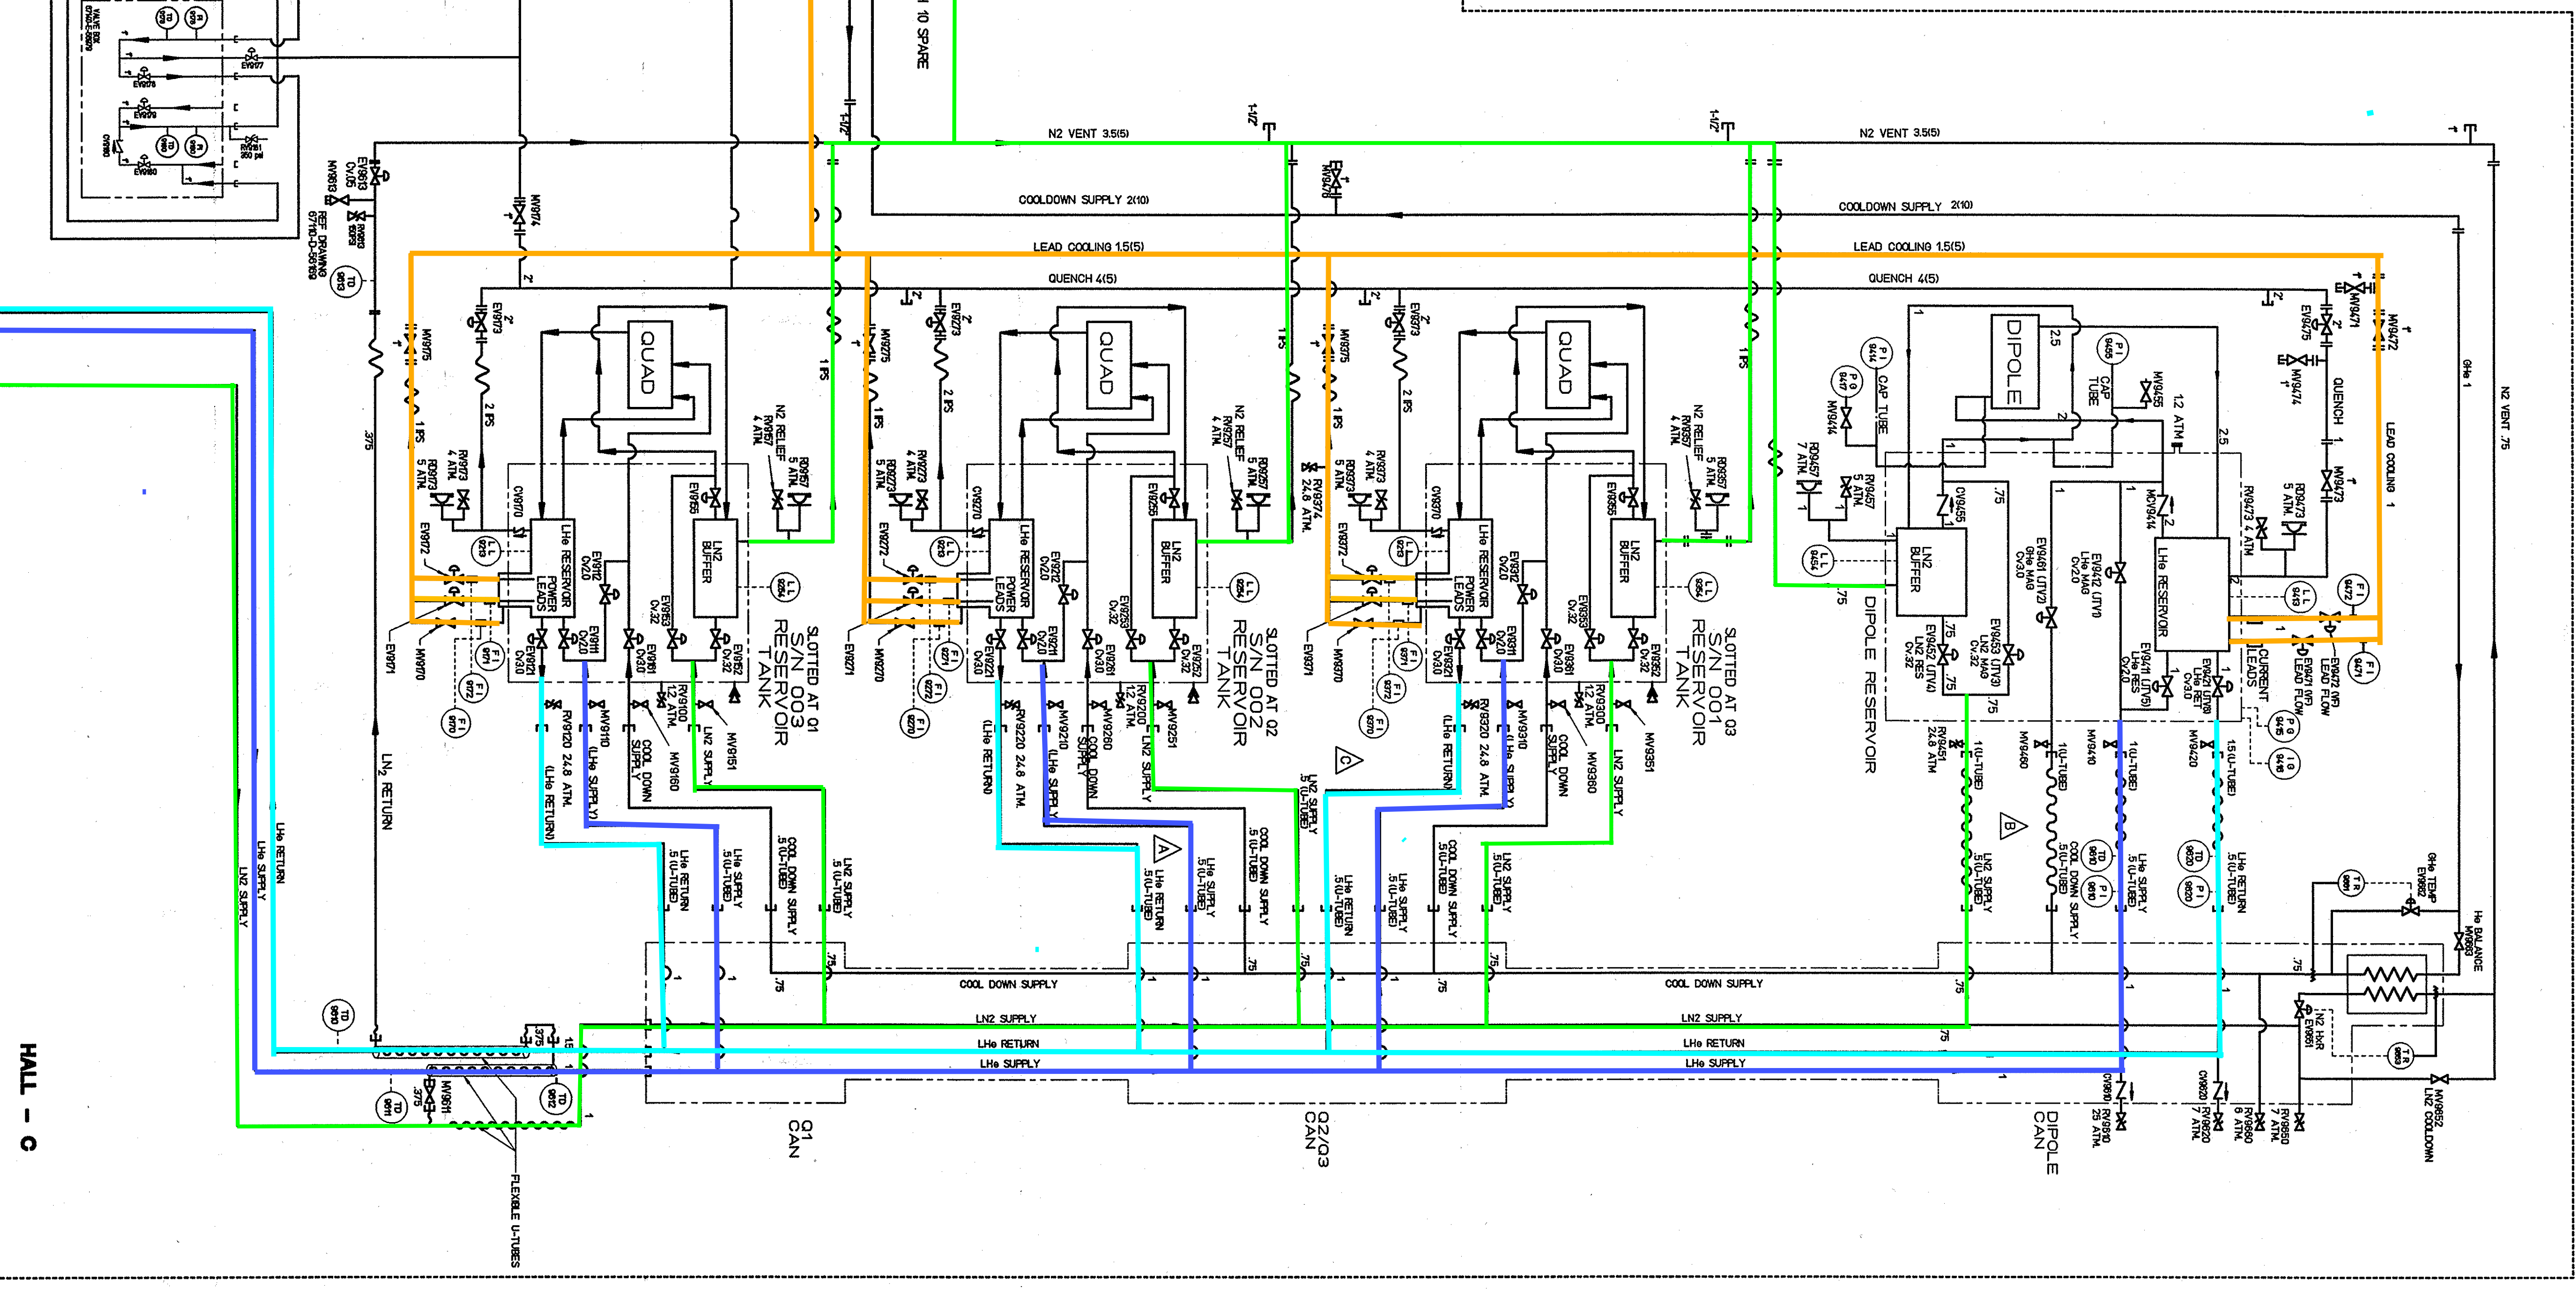

DO NOT SCALE DRAWING		HALL C FLOW DIAGRAM 4.5K SUPPLY, 300K RETURN	
DATE	11/1/96	DESIGNED BY	67140-E-56960
CHECKED	JAMES I. TAKACS	APPROVED FOR CONSTRUCTION	
DRAWN	JAMES I. TAKACS		
DATE	11/1/96		
REVISION			
1			
2			
