
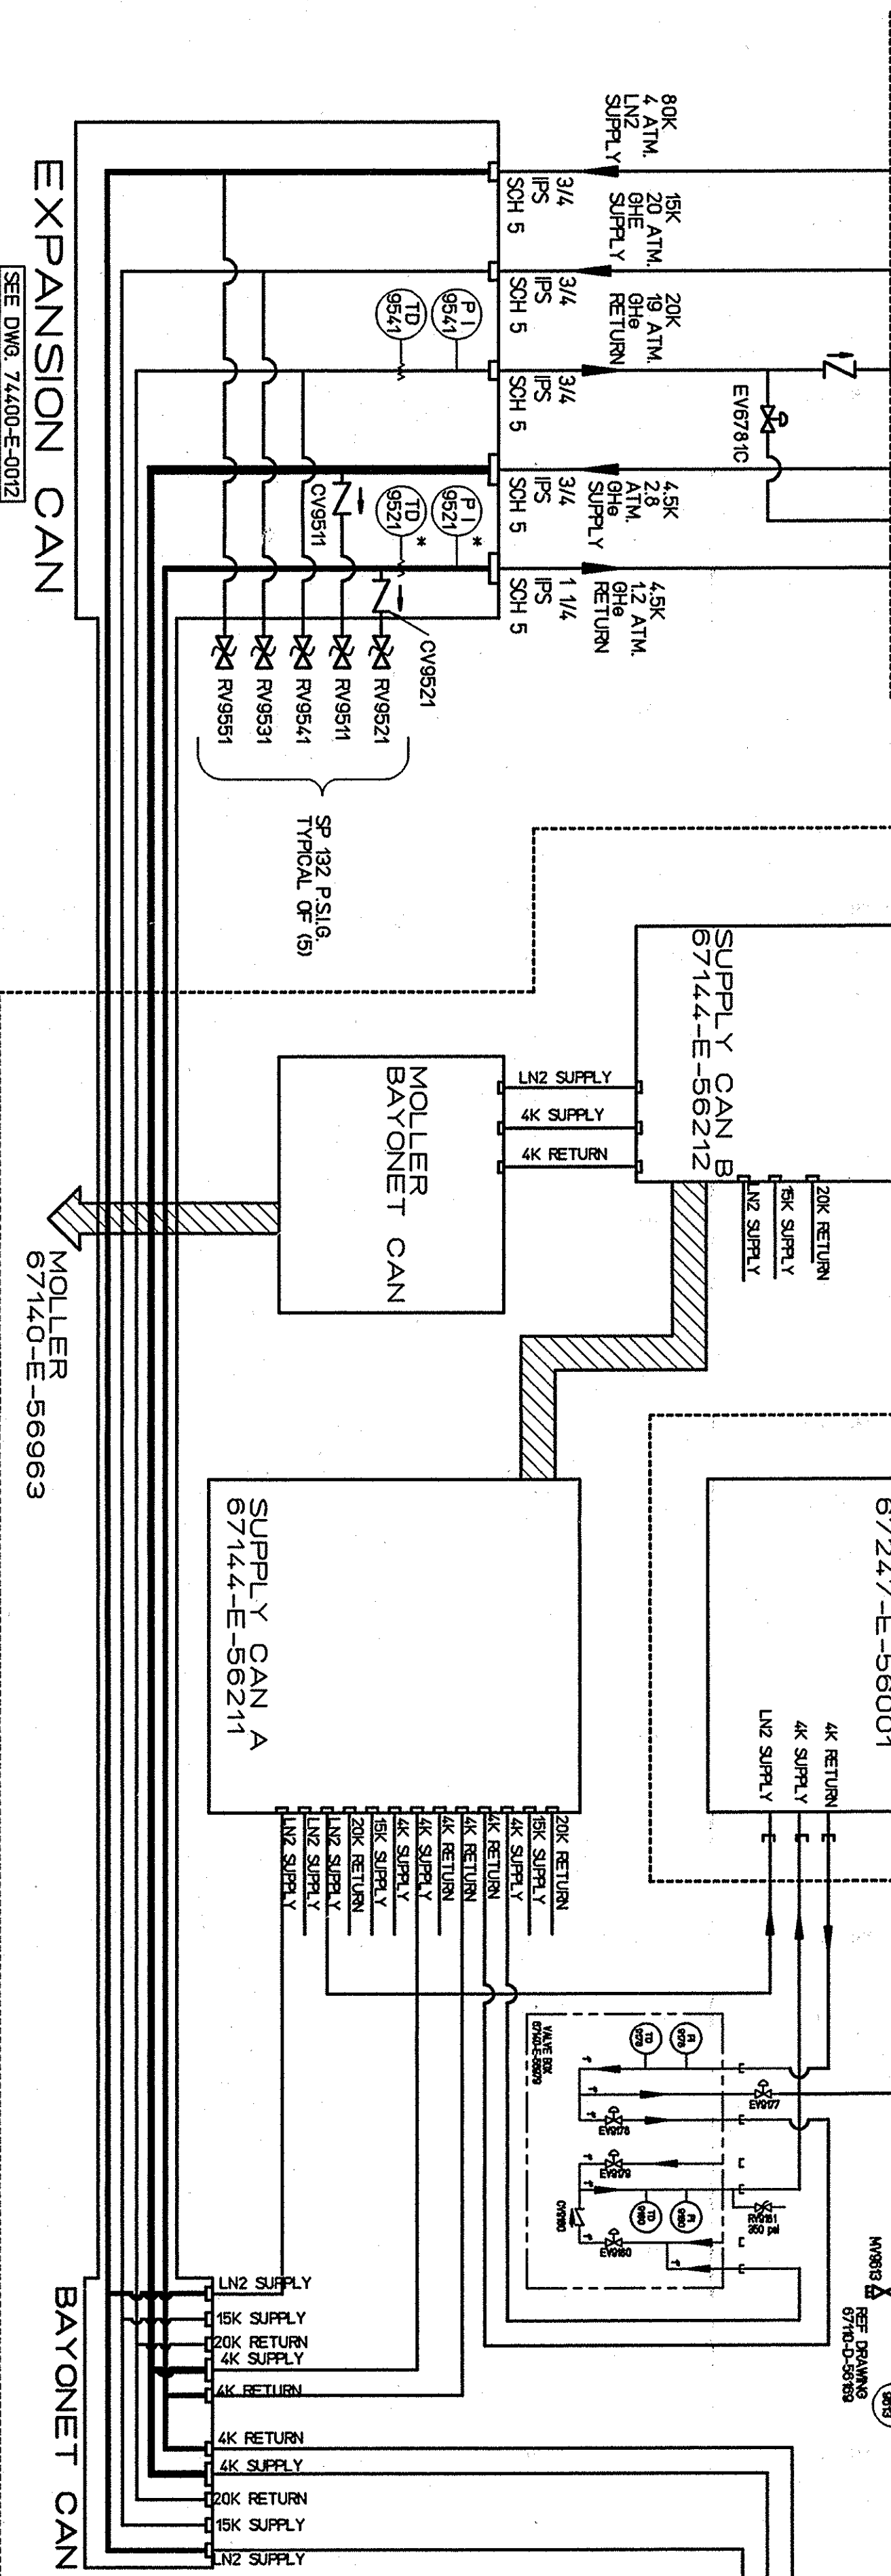
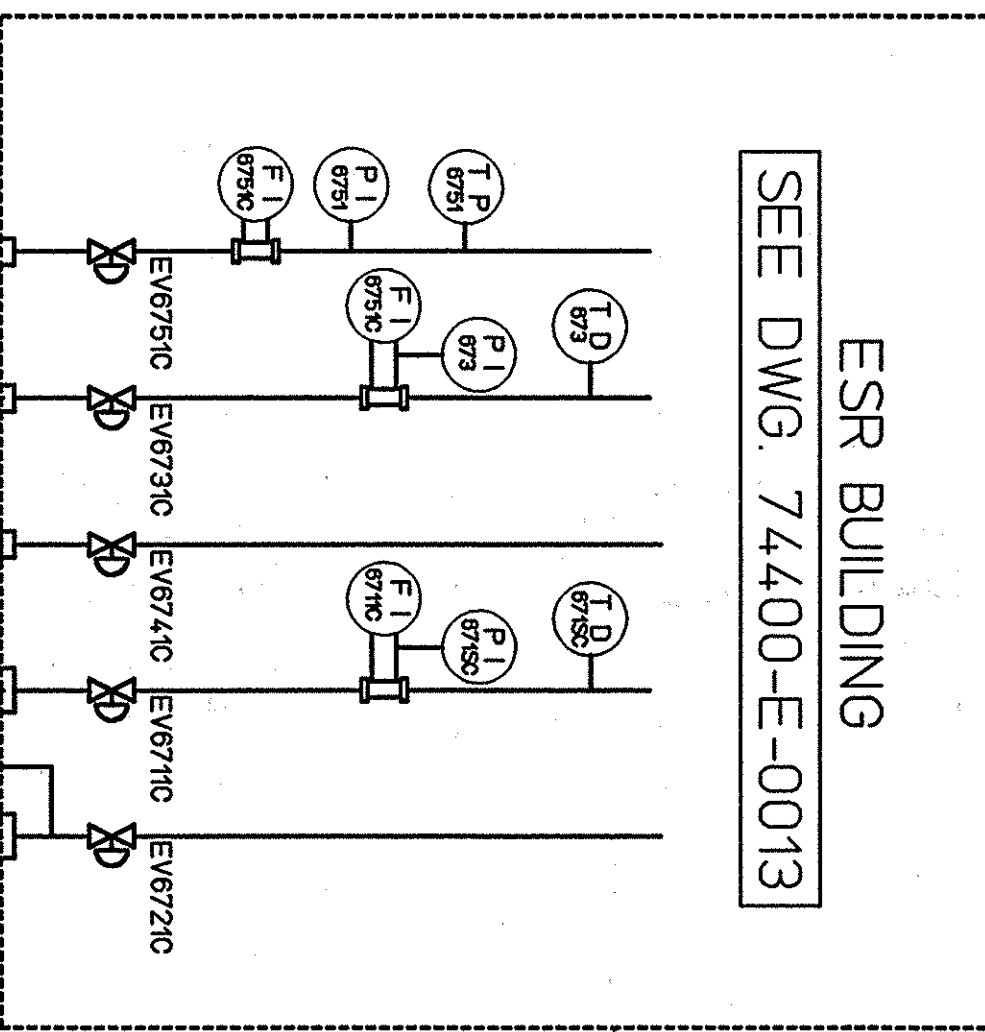
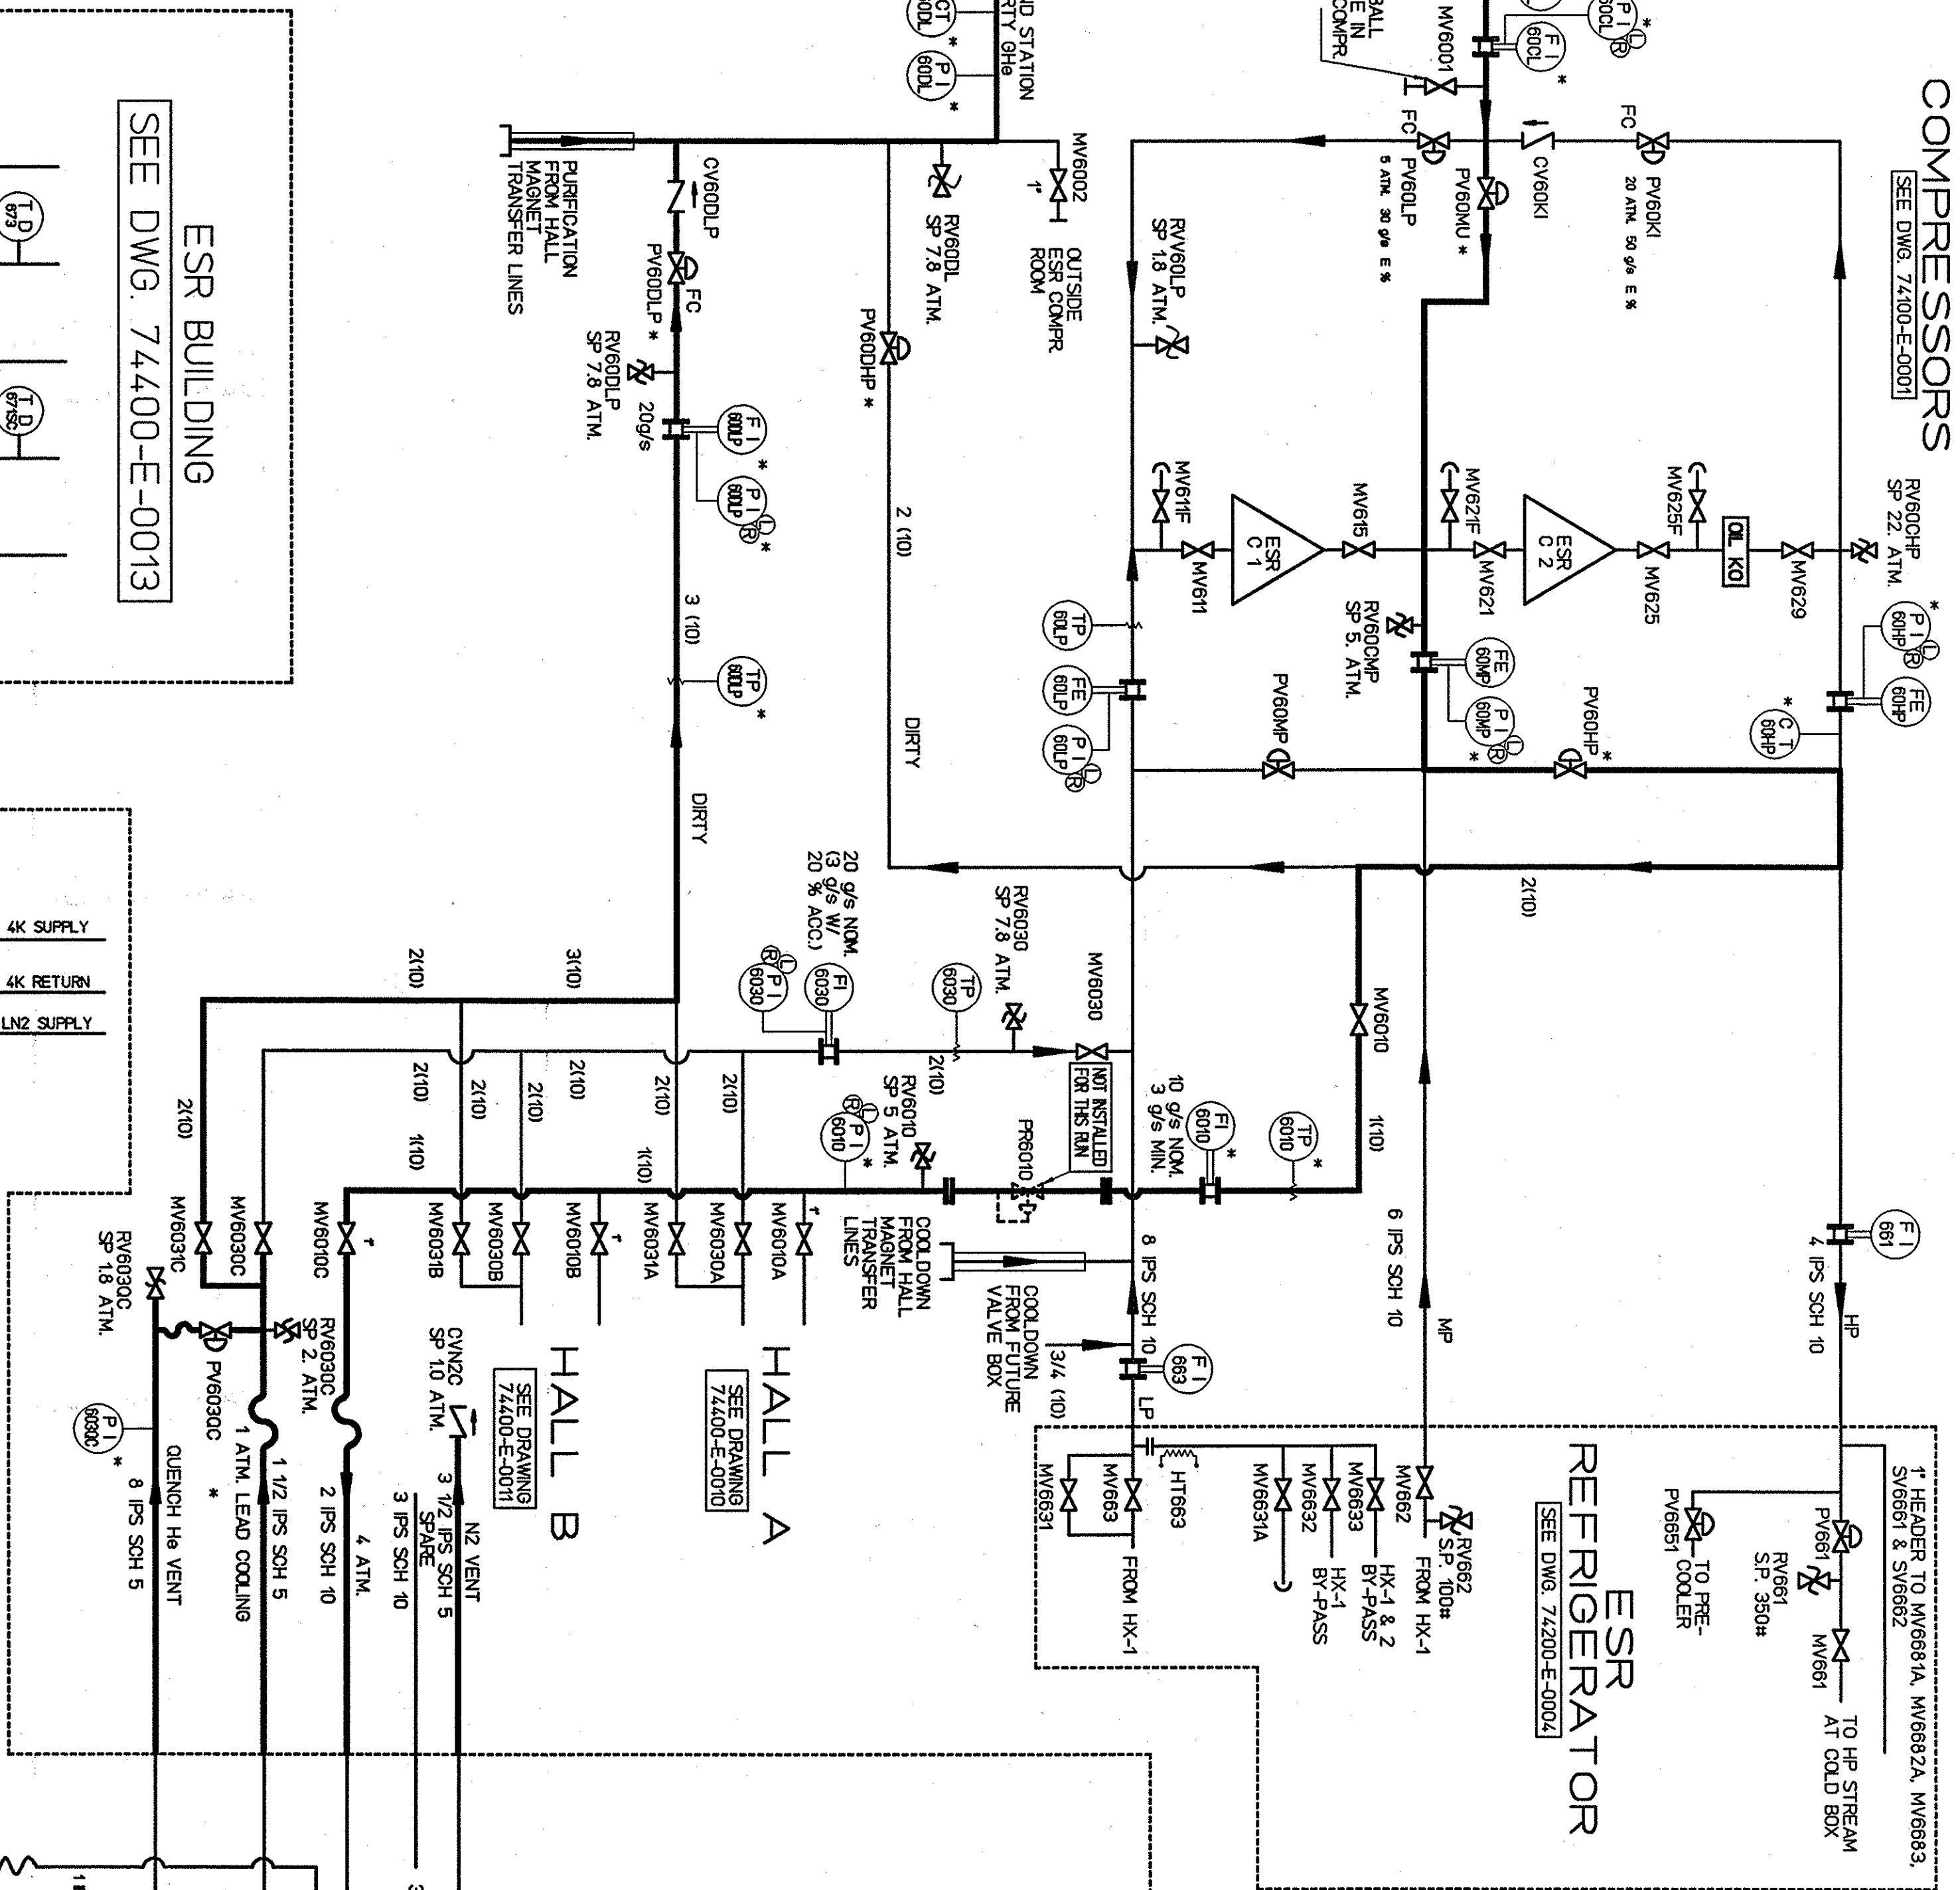
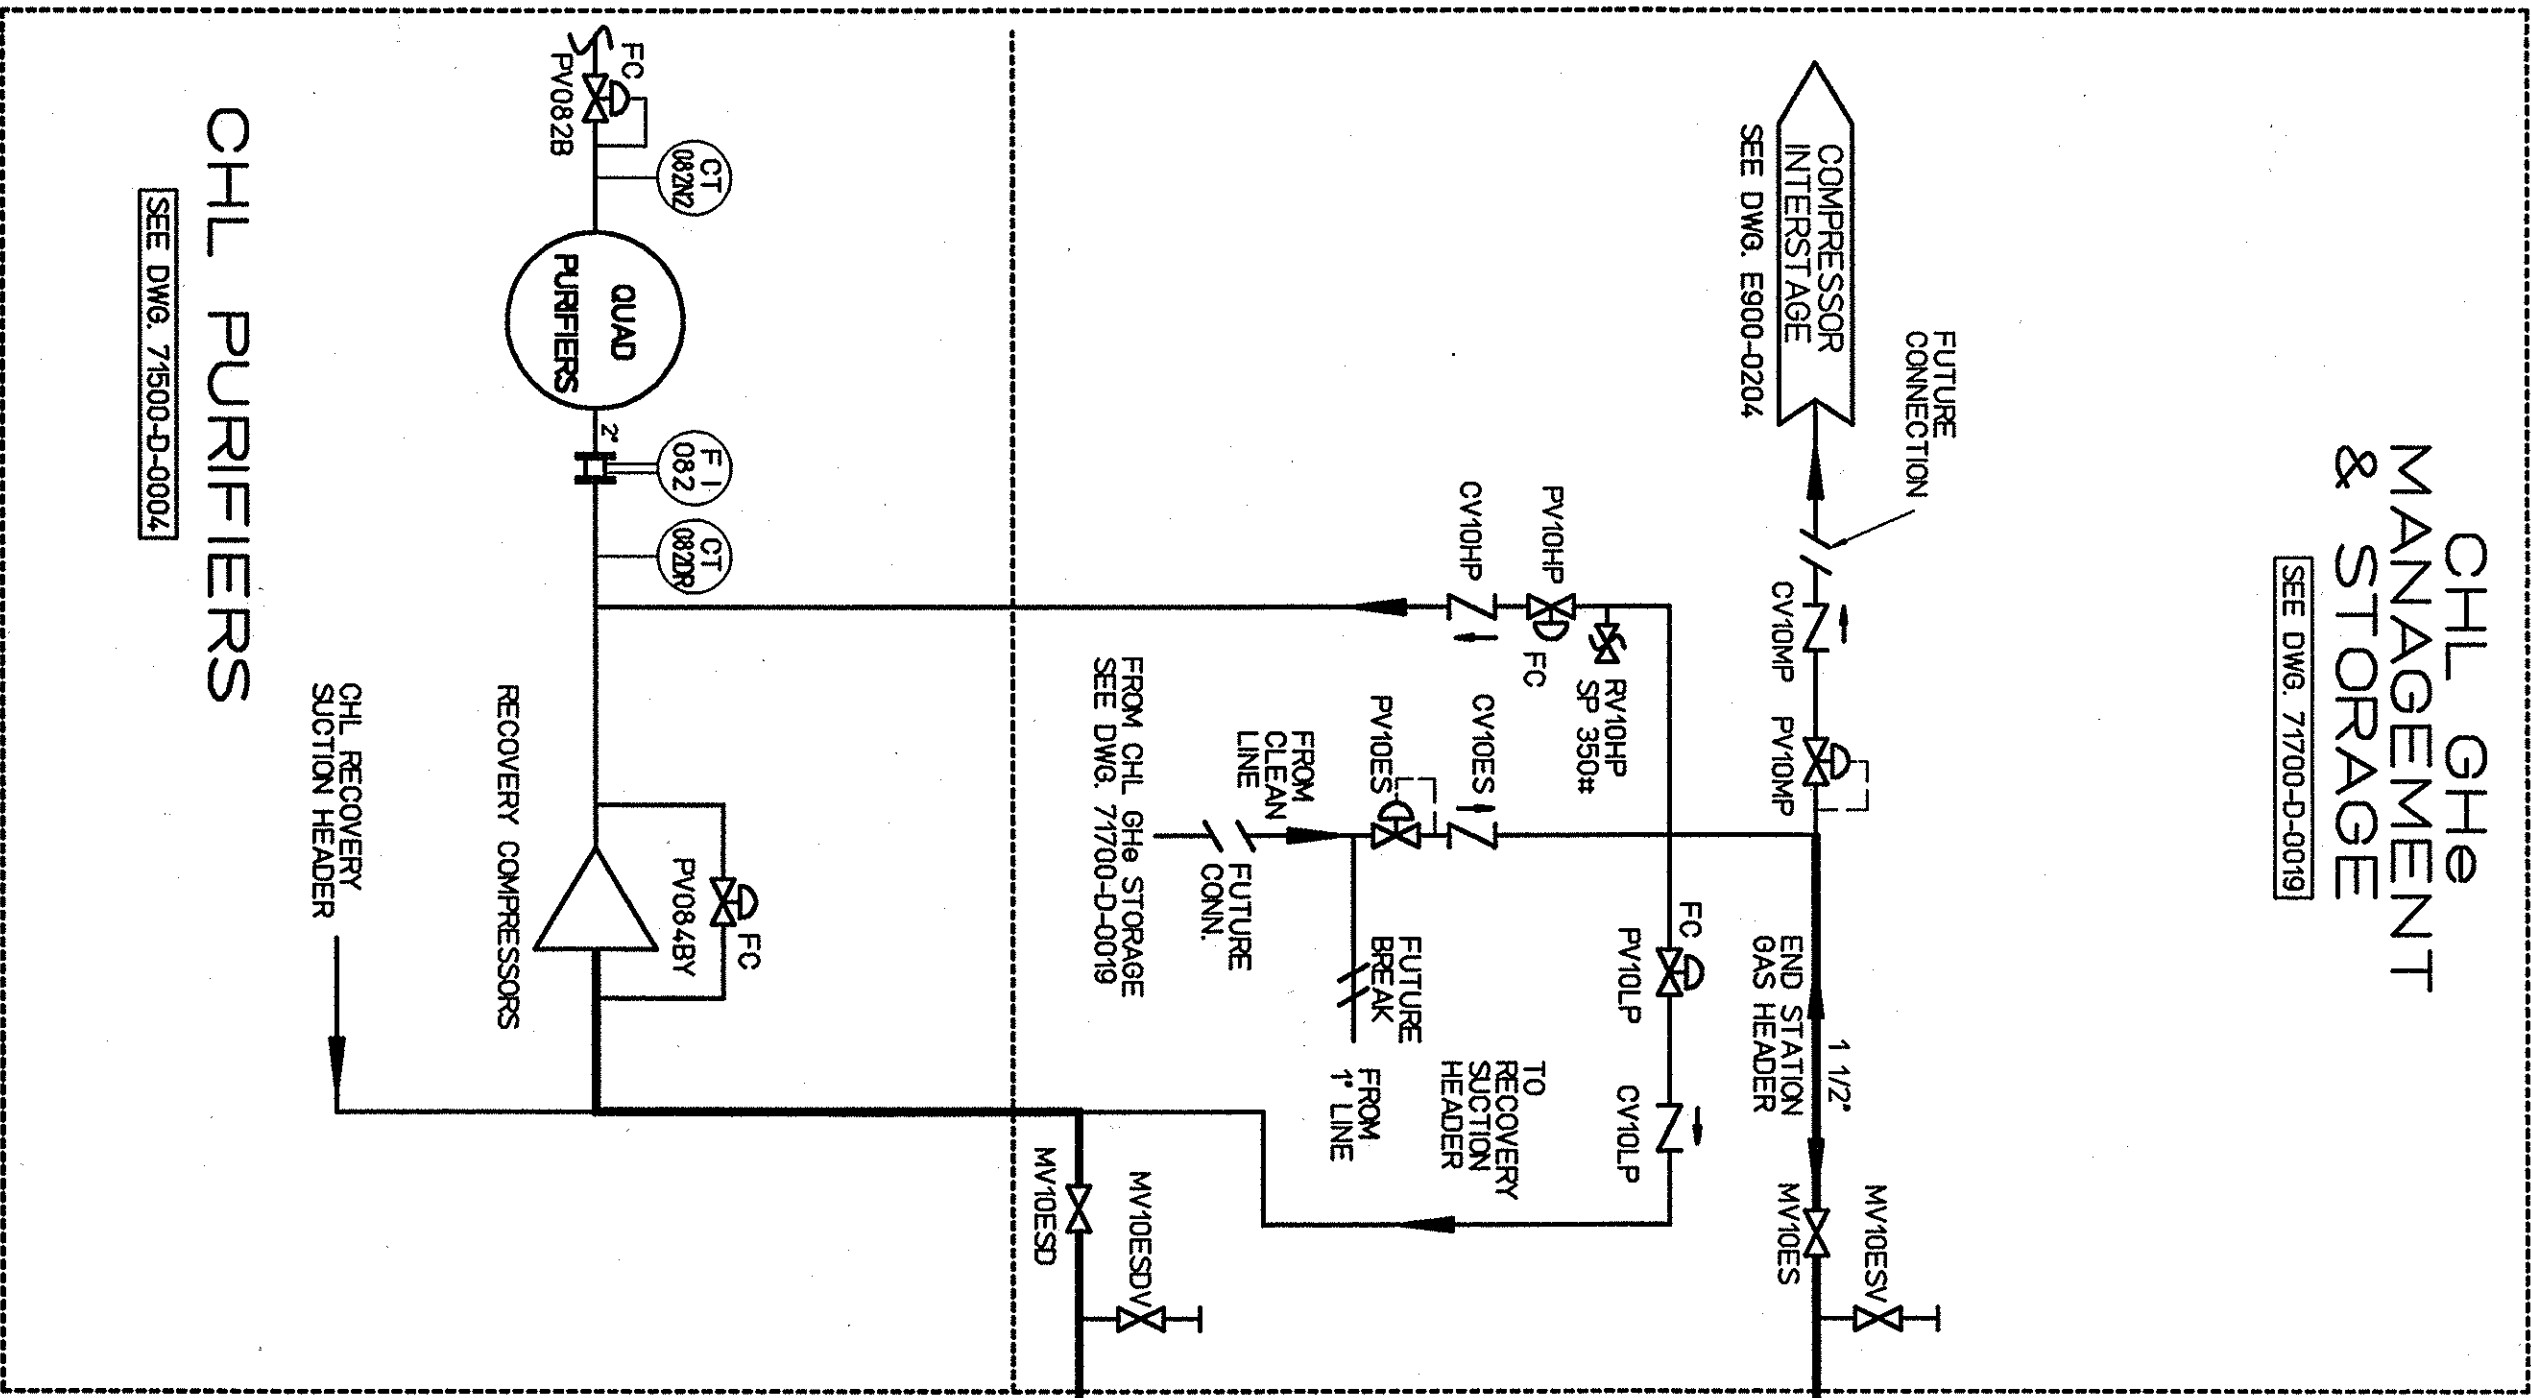


REVISIONS		DESCRIPTION	DRAWN	CHECKED
ZONE	REV		DJH	
A		AS BUILT JUNE 2001	ZOUNO	7-7-01

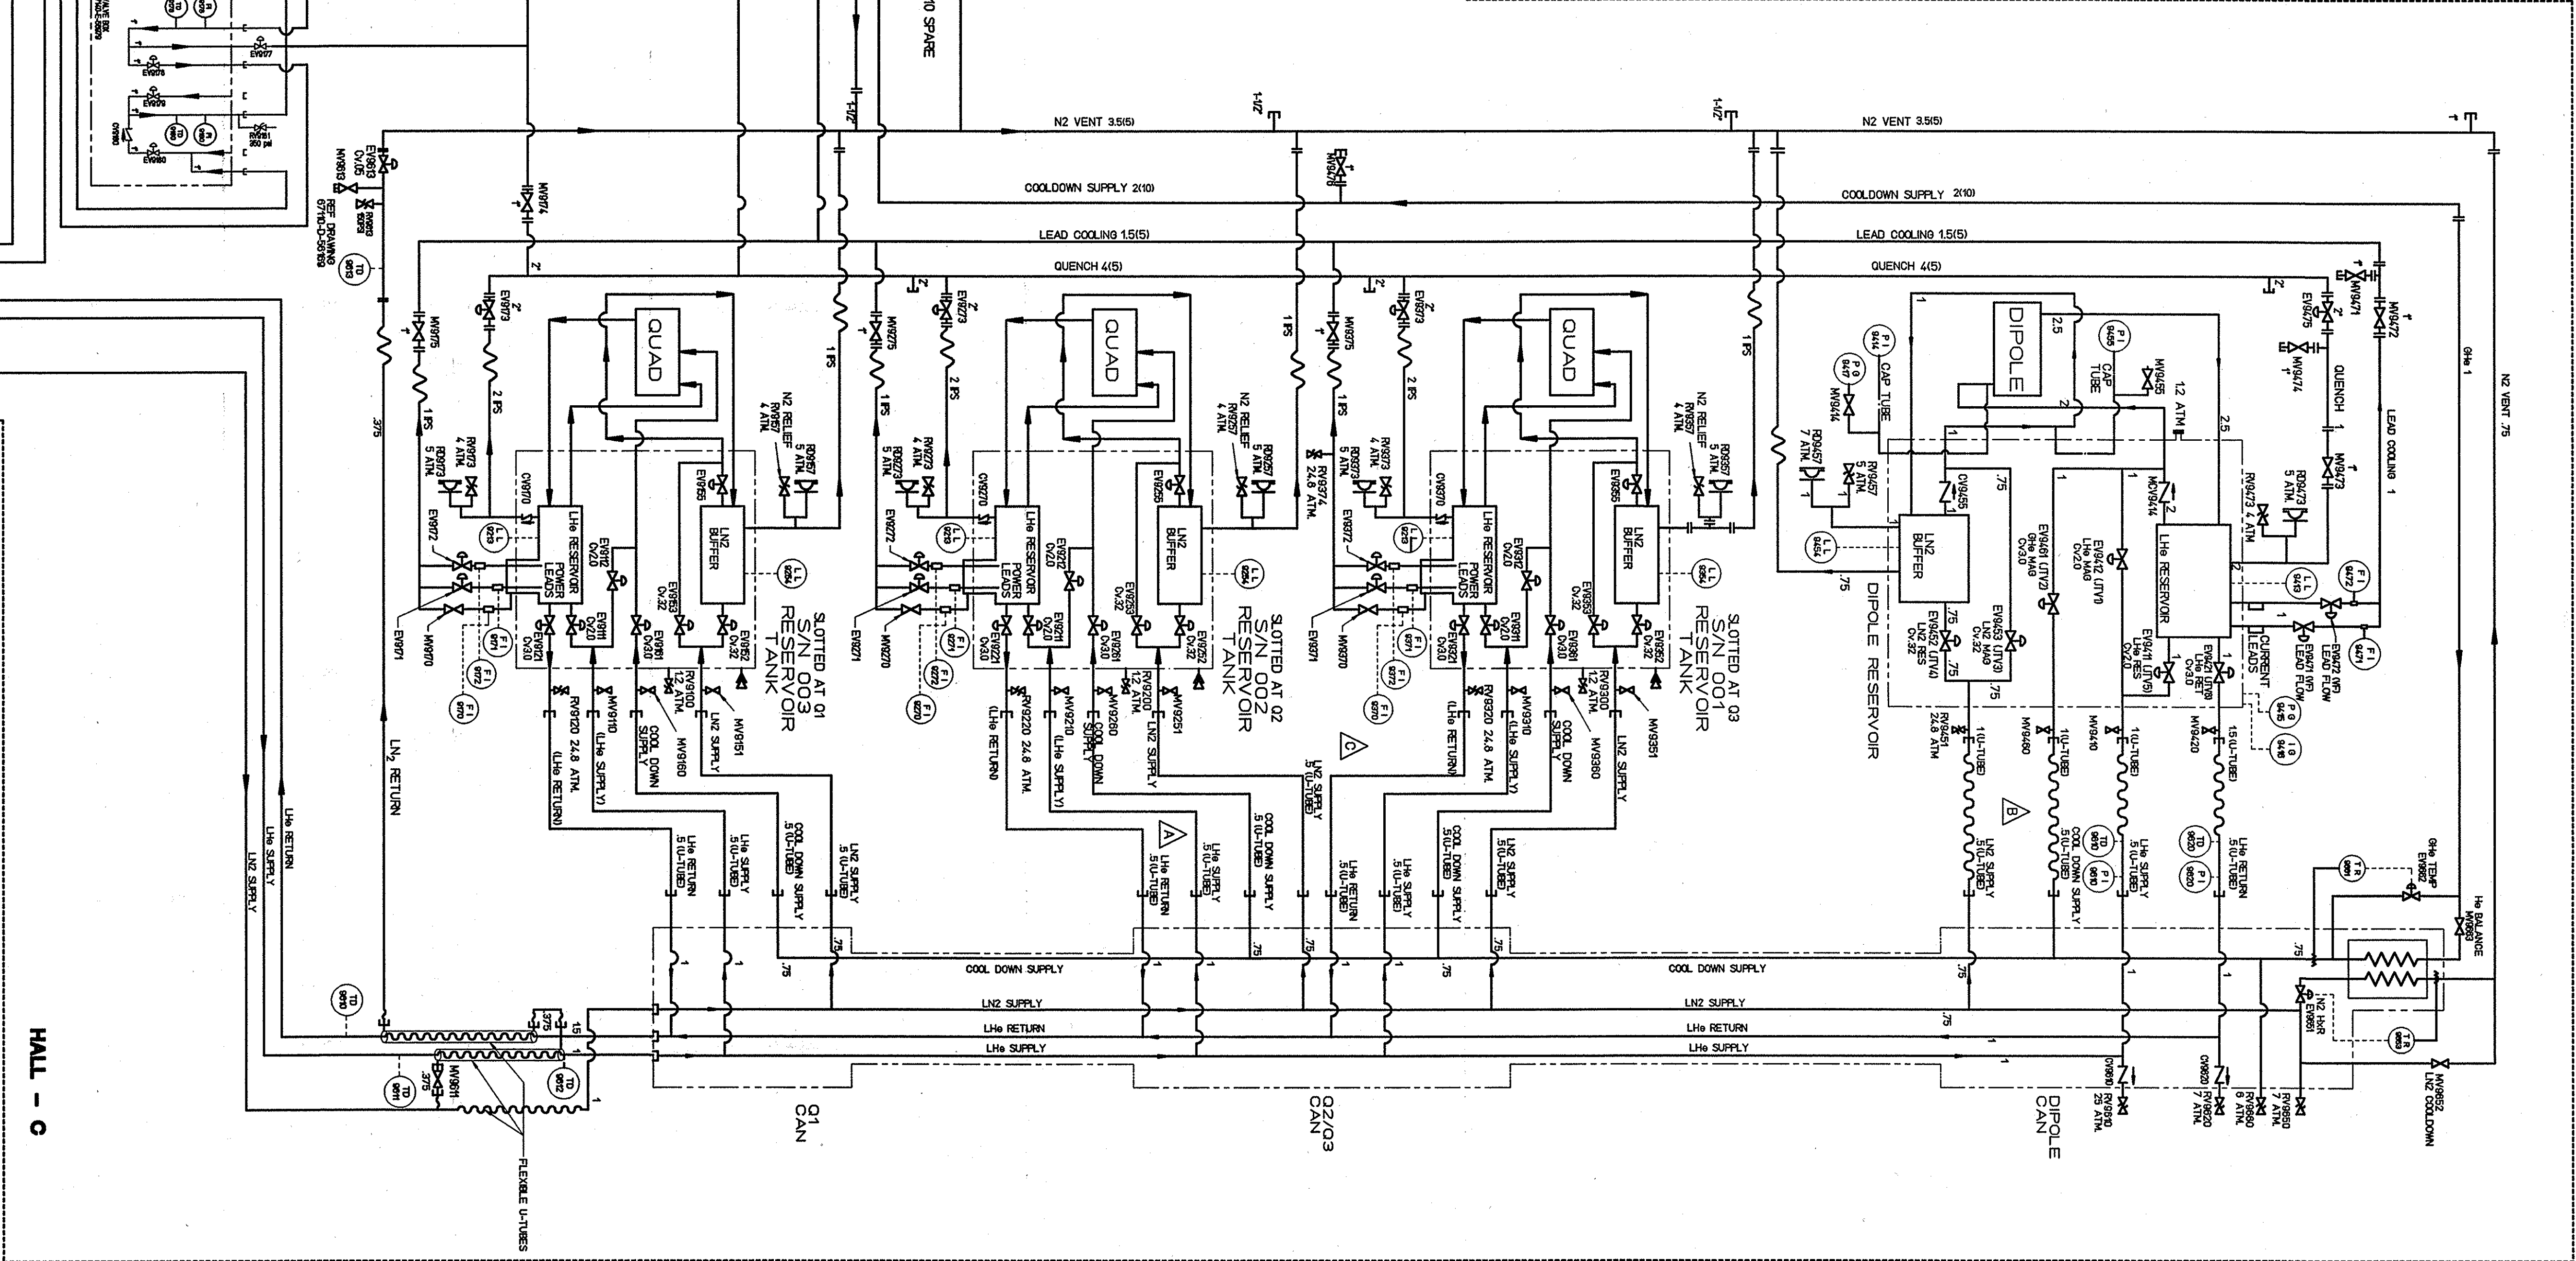

DO NOT SCALE DRAWING		HALL C FLOW DIAGRAM 4.5K SUPPLY, 300K RETURN		REV
FINISH	DATE	CHECKED	DATE	A
DESIGNER & REVIEWER	DATE	APPROVED	DATE	
PULL PRINTING	DATE	APPROVED FOR PRINT	DATE	